

IN THE DRAWINGS:

Please approve the drawing changes as shown in red on the attached marked-up copies of Figures 4A, 4B, 5A, 5B, and 5C. A separate letter to the draftsman indicating the same proposed drawing changes is also enclosed.

## **REMARKS**

As a preliminary matter, Applicants wish to thank Examiner Michel Koczo, Jr. for his courtesy in granting a telephonic interview to discuss the present Application. A telephonic interview was conducted on November 2, 2005. Claims 1 and 18 were discussed, and no prior art was discussed. Agreement with respect to the claims was reached. Particularly, the Examiner agreed to enter an Examiner's Amendment removing the word "wavelet" from the phrase "comparing the located feature pressure signal wavelet" in claim 1, and to remove the term "wavelet" from the phrase "compare the located feature pressure signal wavelet" in claim 18. These changes were agreed upon to avoid lack of antecedent basis for the phrase "located feature pressure signal wavelet" in claims 1 and 18.

The drawings stand objected to because reference characters and lines (see FIG. 2) are stated to not be uniformly drawn. In response, Applicants respectfully submit corrected drawing sheets in compliance with 37 C.F.R. 1.121(d), as well as formal drawings for all Figures. In addition to the drawing objections stated in the Examiner's comments to the Notice of Allowability, Applicants have amended the drawings, as shown on the attached sheets marked up in red, to remove informalities found by Applicants. Applicants also provide a separate letter to the Draftsman also with sheets showing the changes marked up in red.

Applicants also have amended the Specification and the Abstract to the present allowed Application. The proposed amendments are merely formal in nature, do not

introduce new matter, and do not affect the scope of the claims. Therefore, the proposed amendments are permissible under 37 C.F.R. §1.312. Accordingly, approval and entry of this amendment is respectfully requested.

Should the Examiner be of the opinion that further clarification is necessary, or that outstanding issues exist, the Examiner is invited to contact the undersigned attorney.

Respectfully submitted,

GREER, BURNS & CRAIN, LTD.

**Customer No. 24978**

December 2, 2005

300 South Wacker Drive  
Suite 2500  
Chicago, Illinois 60606  
Telephone: (312) 360-0080  
Facsimile: (312) 360-9315  
P:\DOCS\1201\68320\9Q6042.DOC

By   
Arik B. Ranson  
Registration No. 43,874

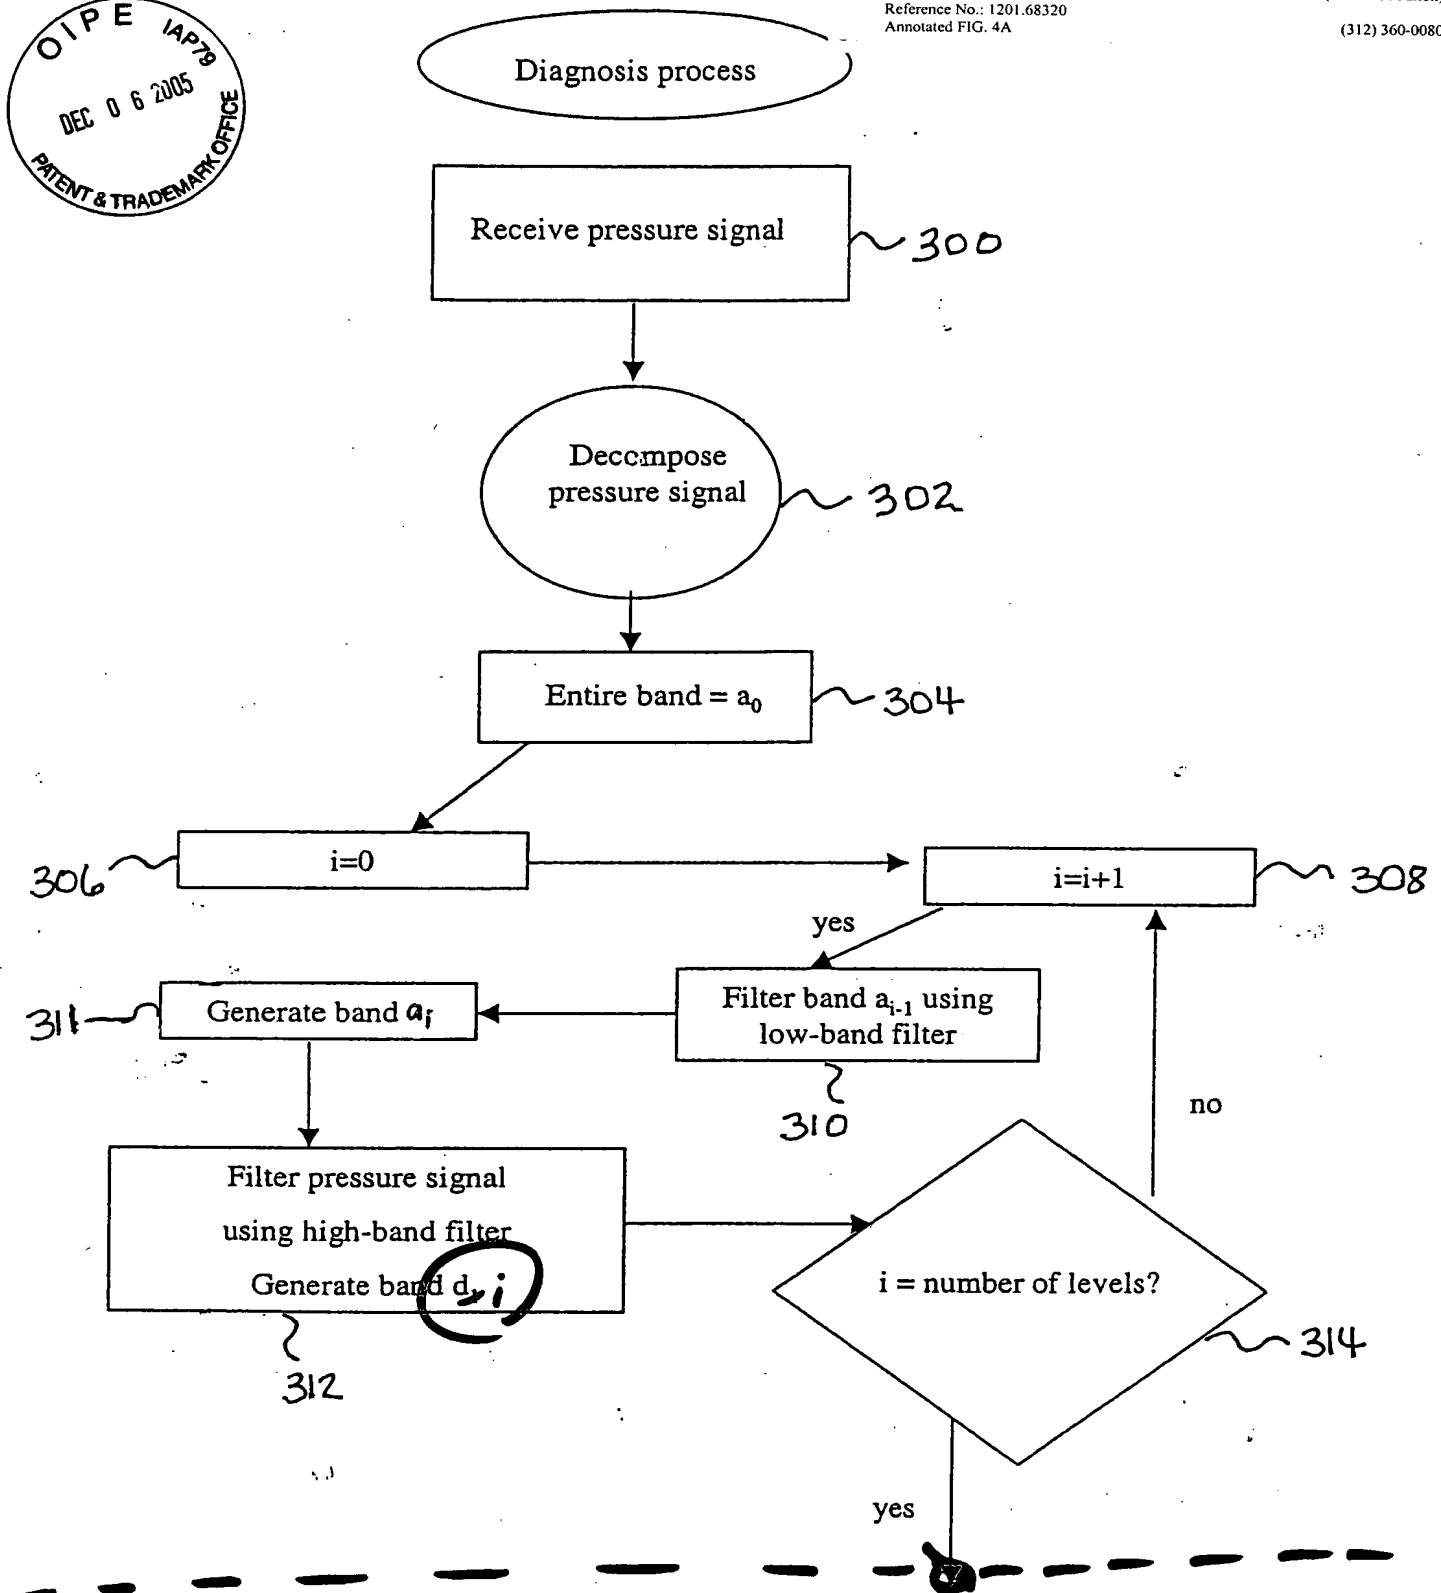


FIG. 4A

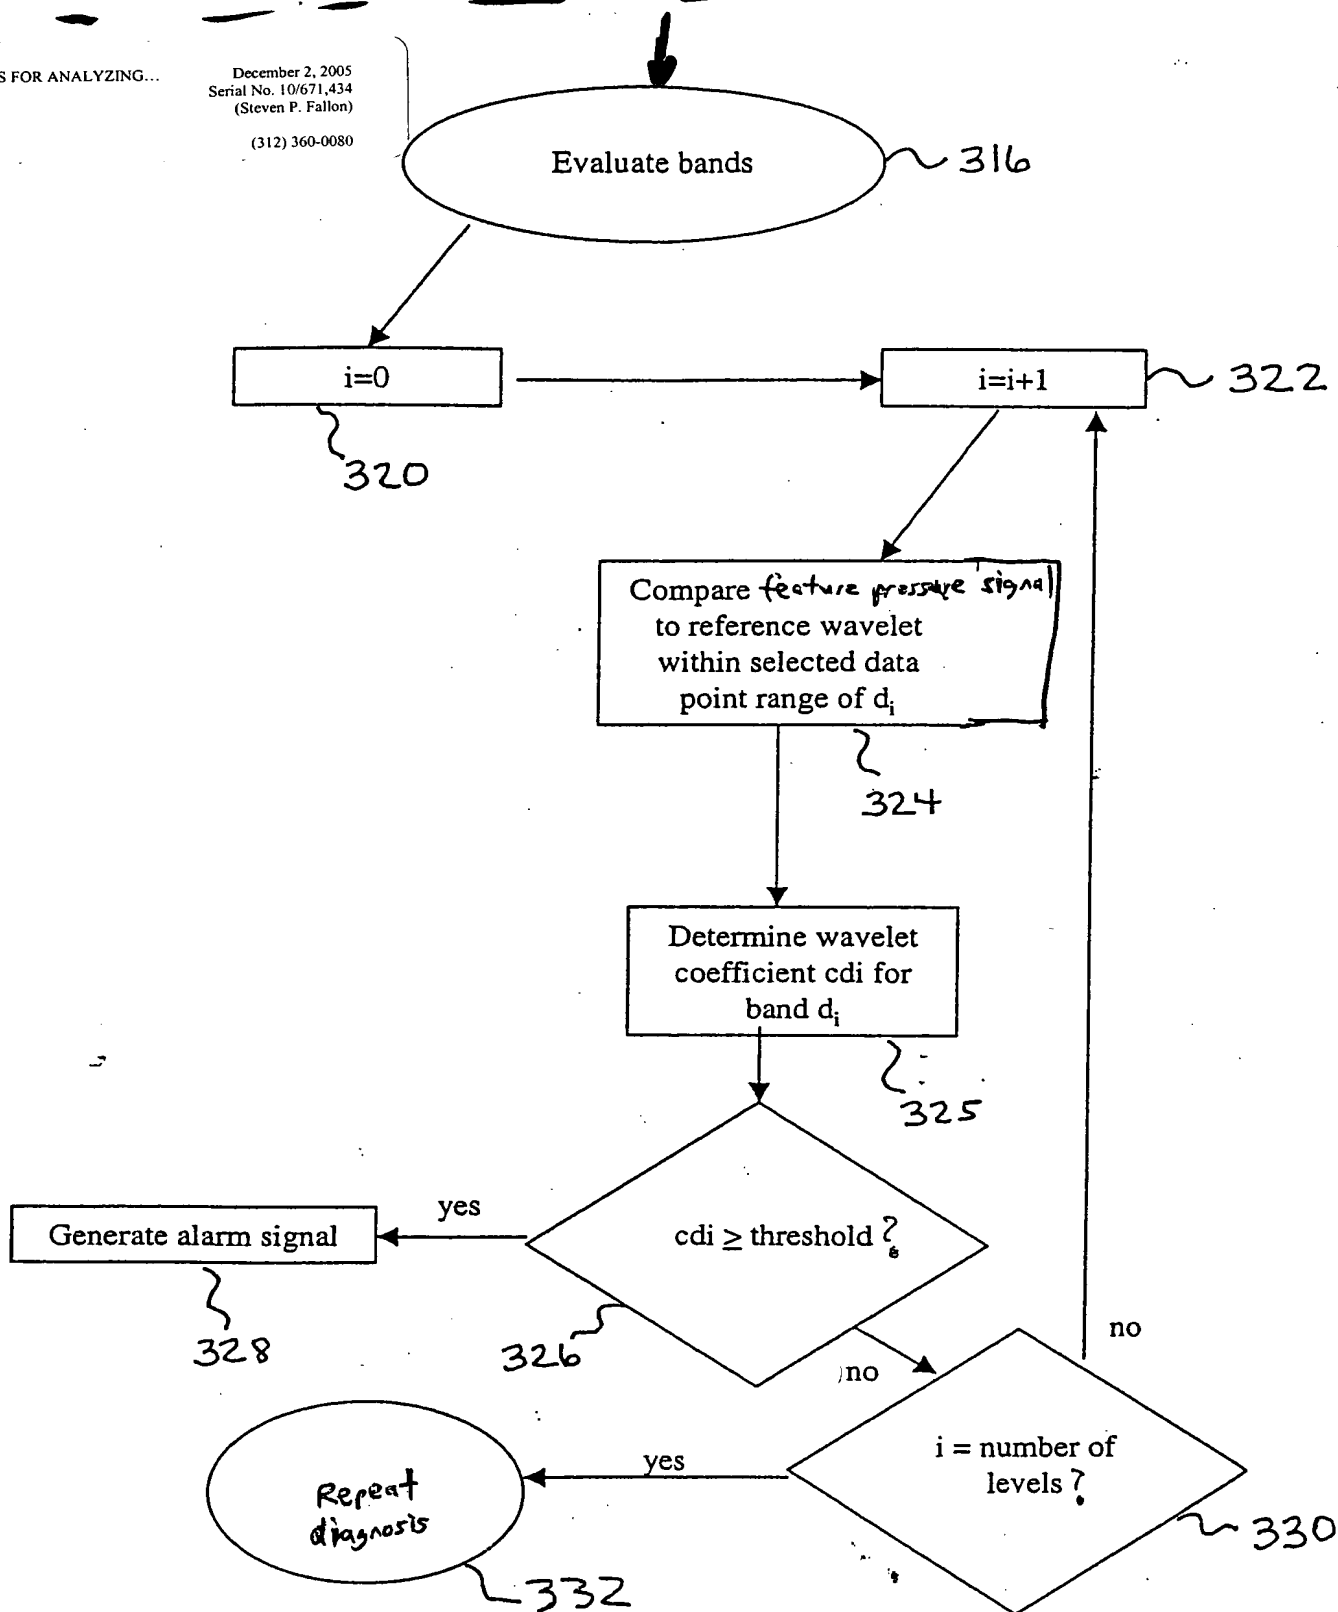


FIG. 4B

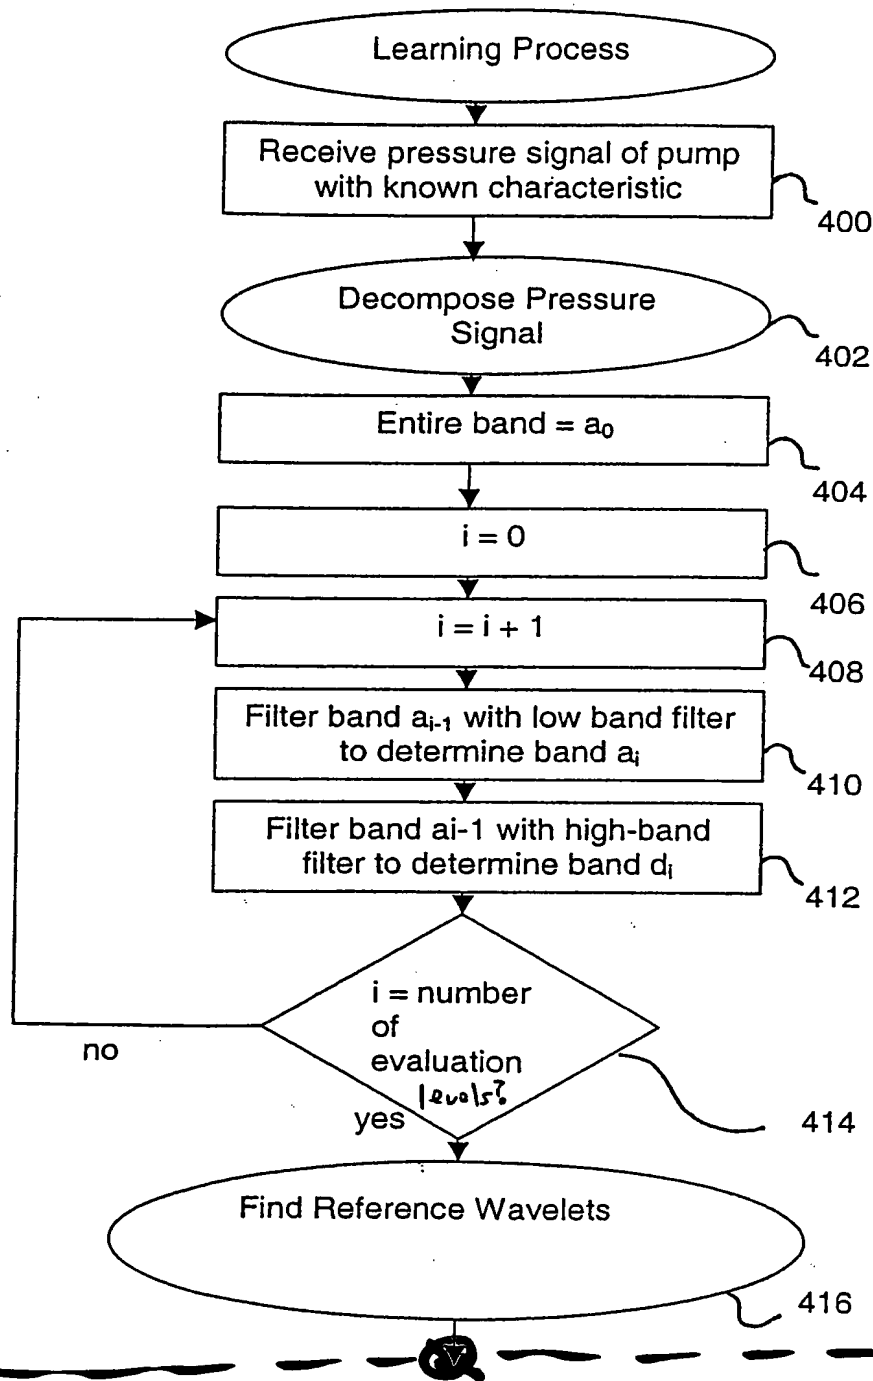


FIG. 5A

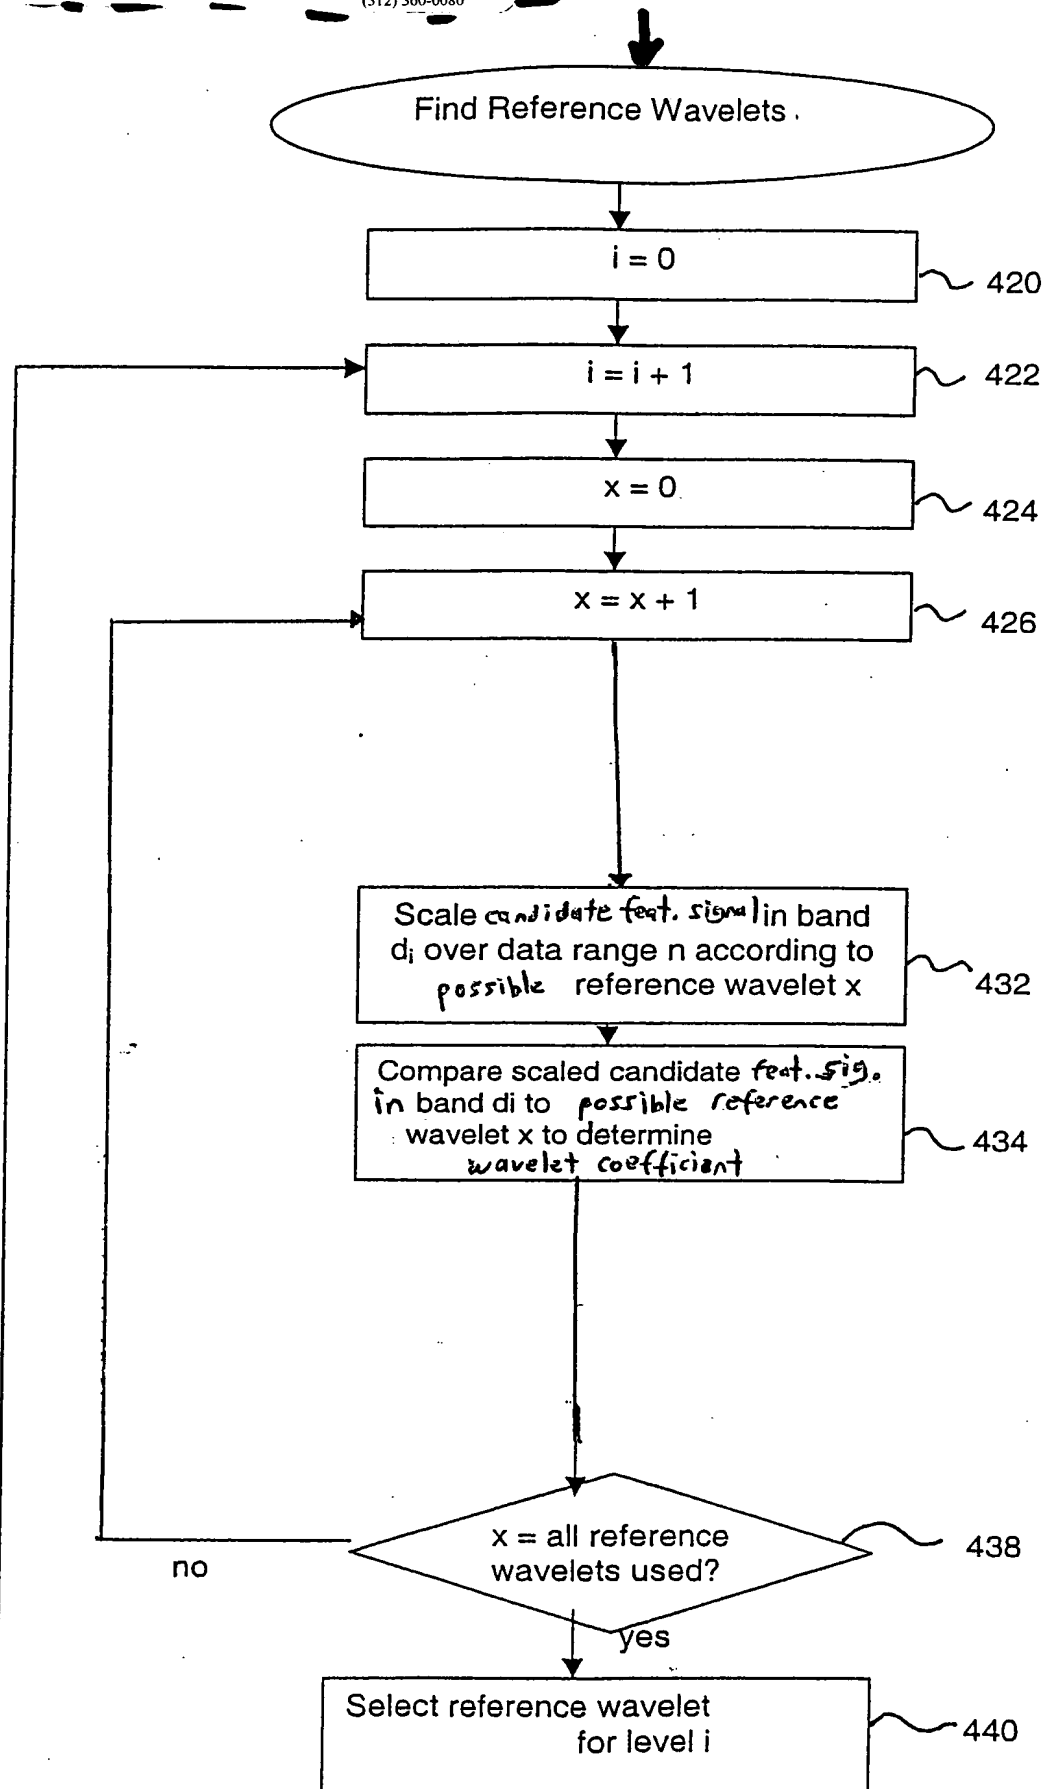


FIG. 5B

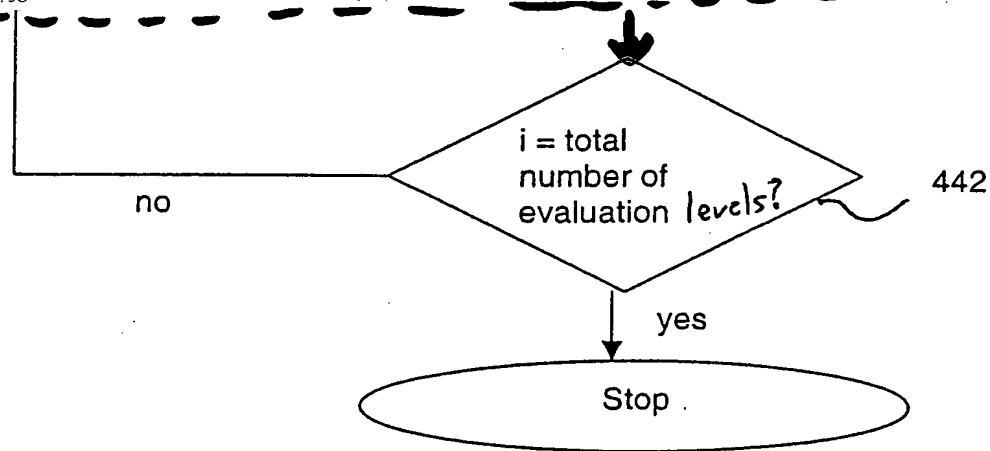


FIG. 5C